

PROJECT

SAWGRASS TECHNOLOGY PARK

SUITE A-210

1601 NW 136TH AVE
SUNRISE
FLORIDA

CONSULTANT

REVISIONS

No.	DATE	DESCRIPTION

SIGNATURES OF APPROVAL ADDITIONS, ALTERATIONS,
OR REVISIONS TO THESE DRAWINGS AFTER APPROVAL
HAS BEEN GIVEN, CONSTITUTE A CHANGE IN THE
SCOPE OF WORK AS OUTLINED AND WILL BE
ACCOMPLISHED AT THE CLIENT'S EXPENSE.

CLIENT: _____ DATE: _____

PROJECT PHASE


- SITE PLANNING
- SCHEMATIC DESIGN
- DESIGN DEVELOPMENT
- CONSTRUCTION DOCUMENTS

SCHEMATIC SPACE PLAN


PROJECT NUMBER: STC1601.00
ISSUED: 1/24/23
DRAWN BY: EMG
CHECKED BY: MAB
FILENAME: STC1601SDP.dwg

SEAL SHEET

SP-1

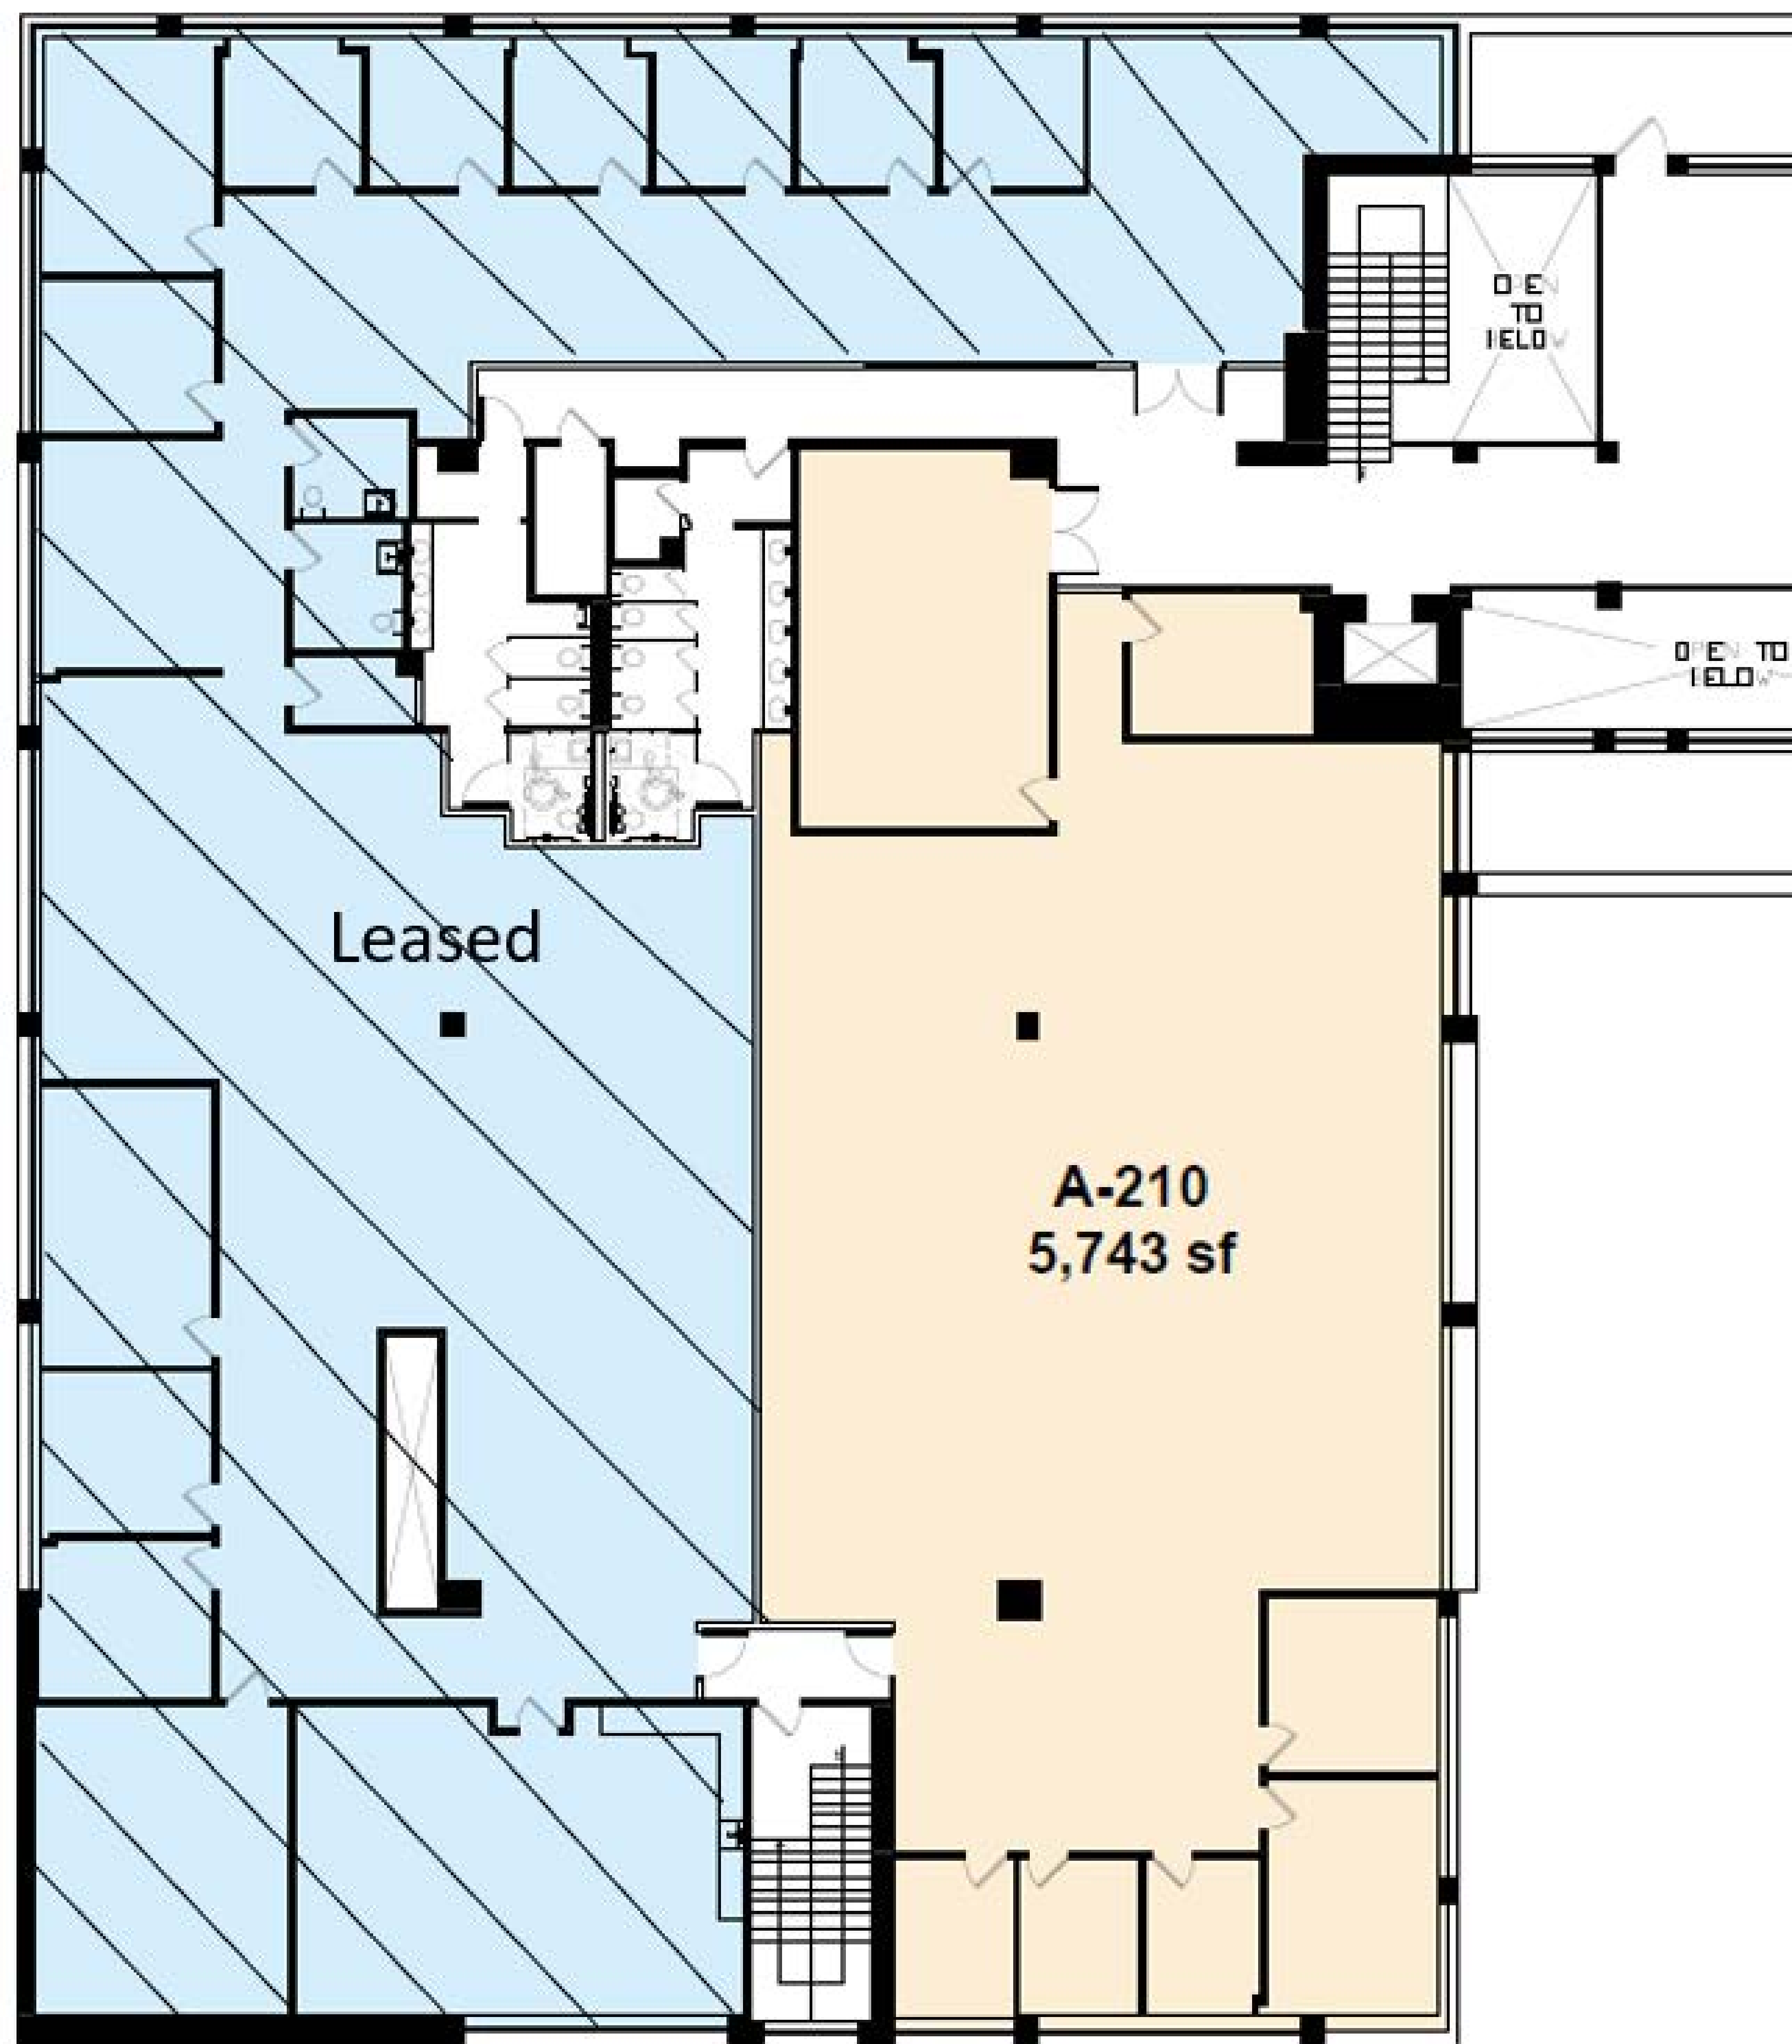

WALL STYLES

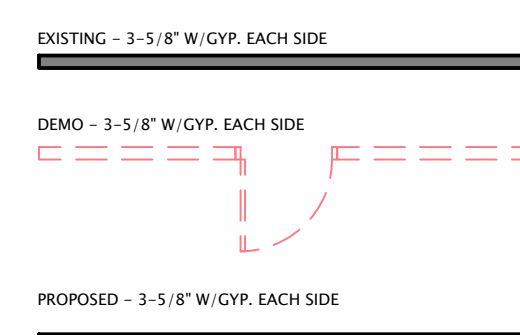

NOTE:
FURNITURE IS SHOWN FOR ILLUSTRATIVE PURPOSES ONLY. TENANT IS RESPONSIBLE FOR ENSURING THAT ALL EXISTING & NEW FURNITURE WILL FIT IN APPLICABLE ROOMS.
ALL ROOM SIZES ARE APPROXIMATE